


N 89°57'09"E
5267.88'

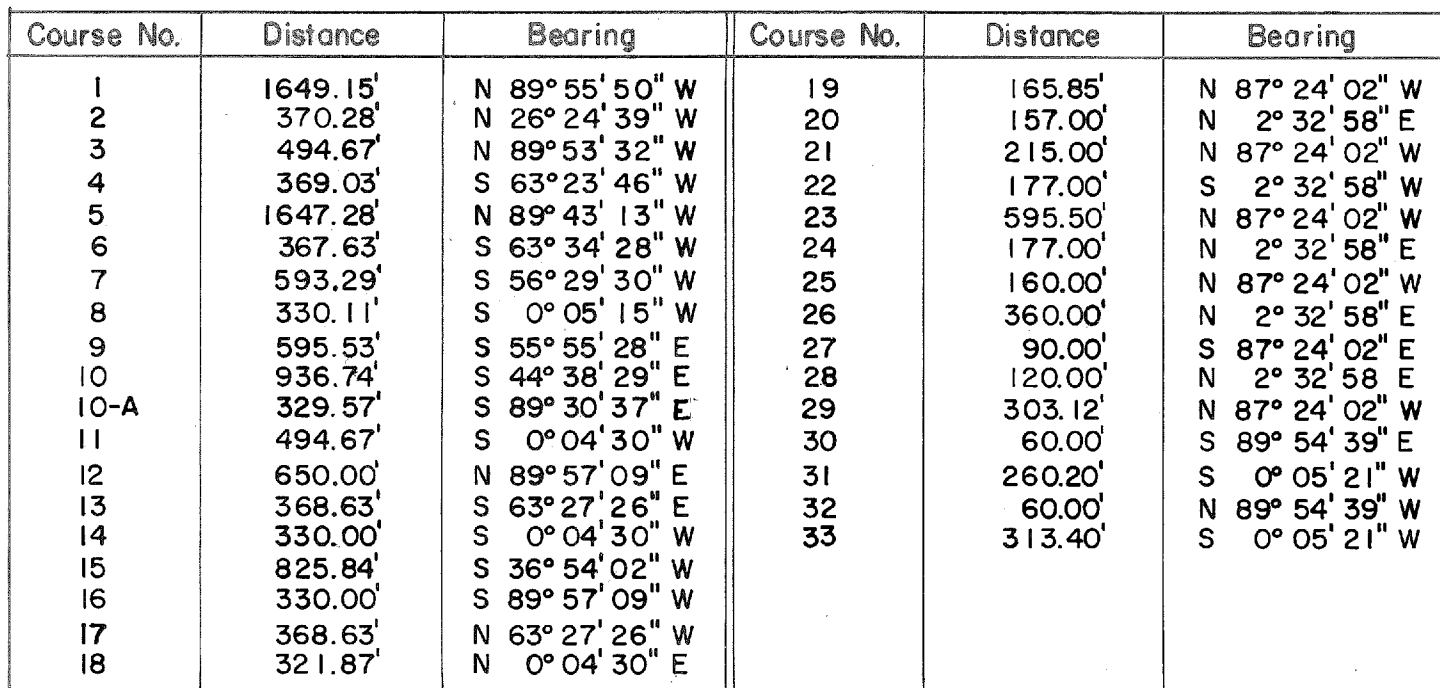


Date: August , 1965

I, James E. Curry, a Registered Professional Engineer, do hereby certify that the above plat is a true and accurate survey of Sec. 1, T9N, R16E as made under my supervision.

○	5/8" Rods w/Caps
△	C. of E. Mon.
	Measured Line
	Calculated Line
□	Orig. Cor. Stone

James E. Curry
JAMES E. CURRY
Reg. Prof. Eng'r. No. 1872

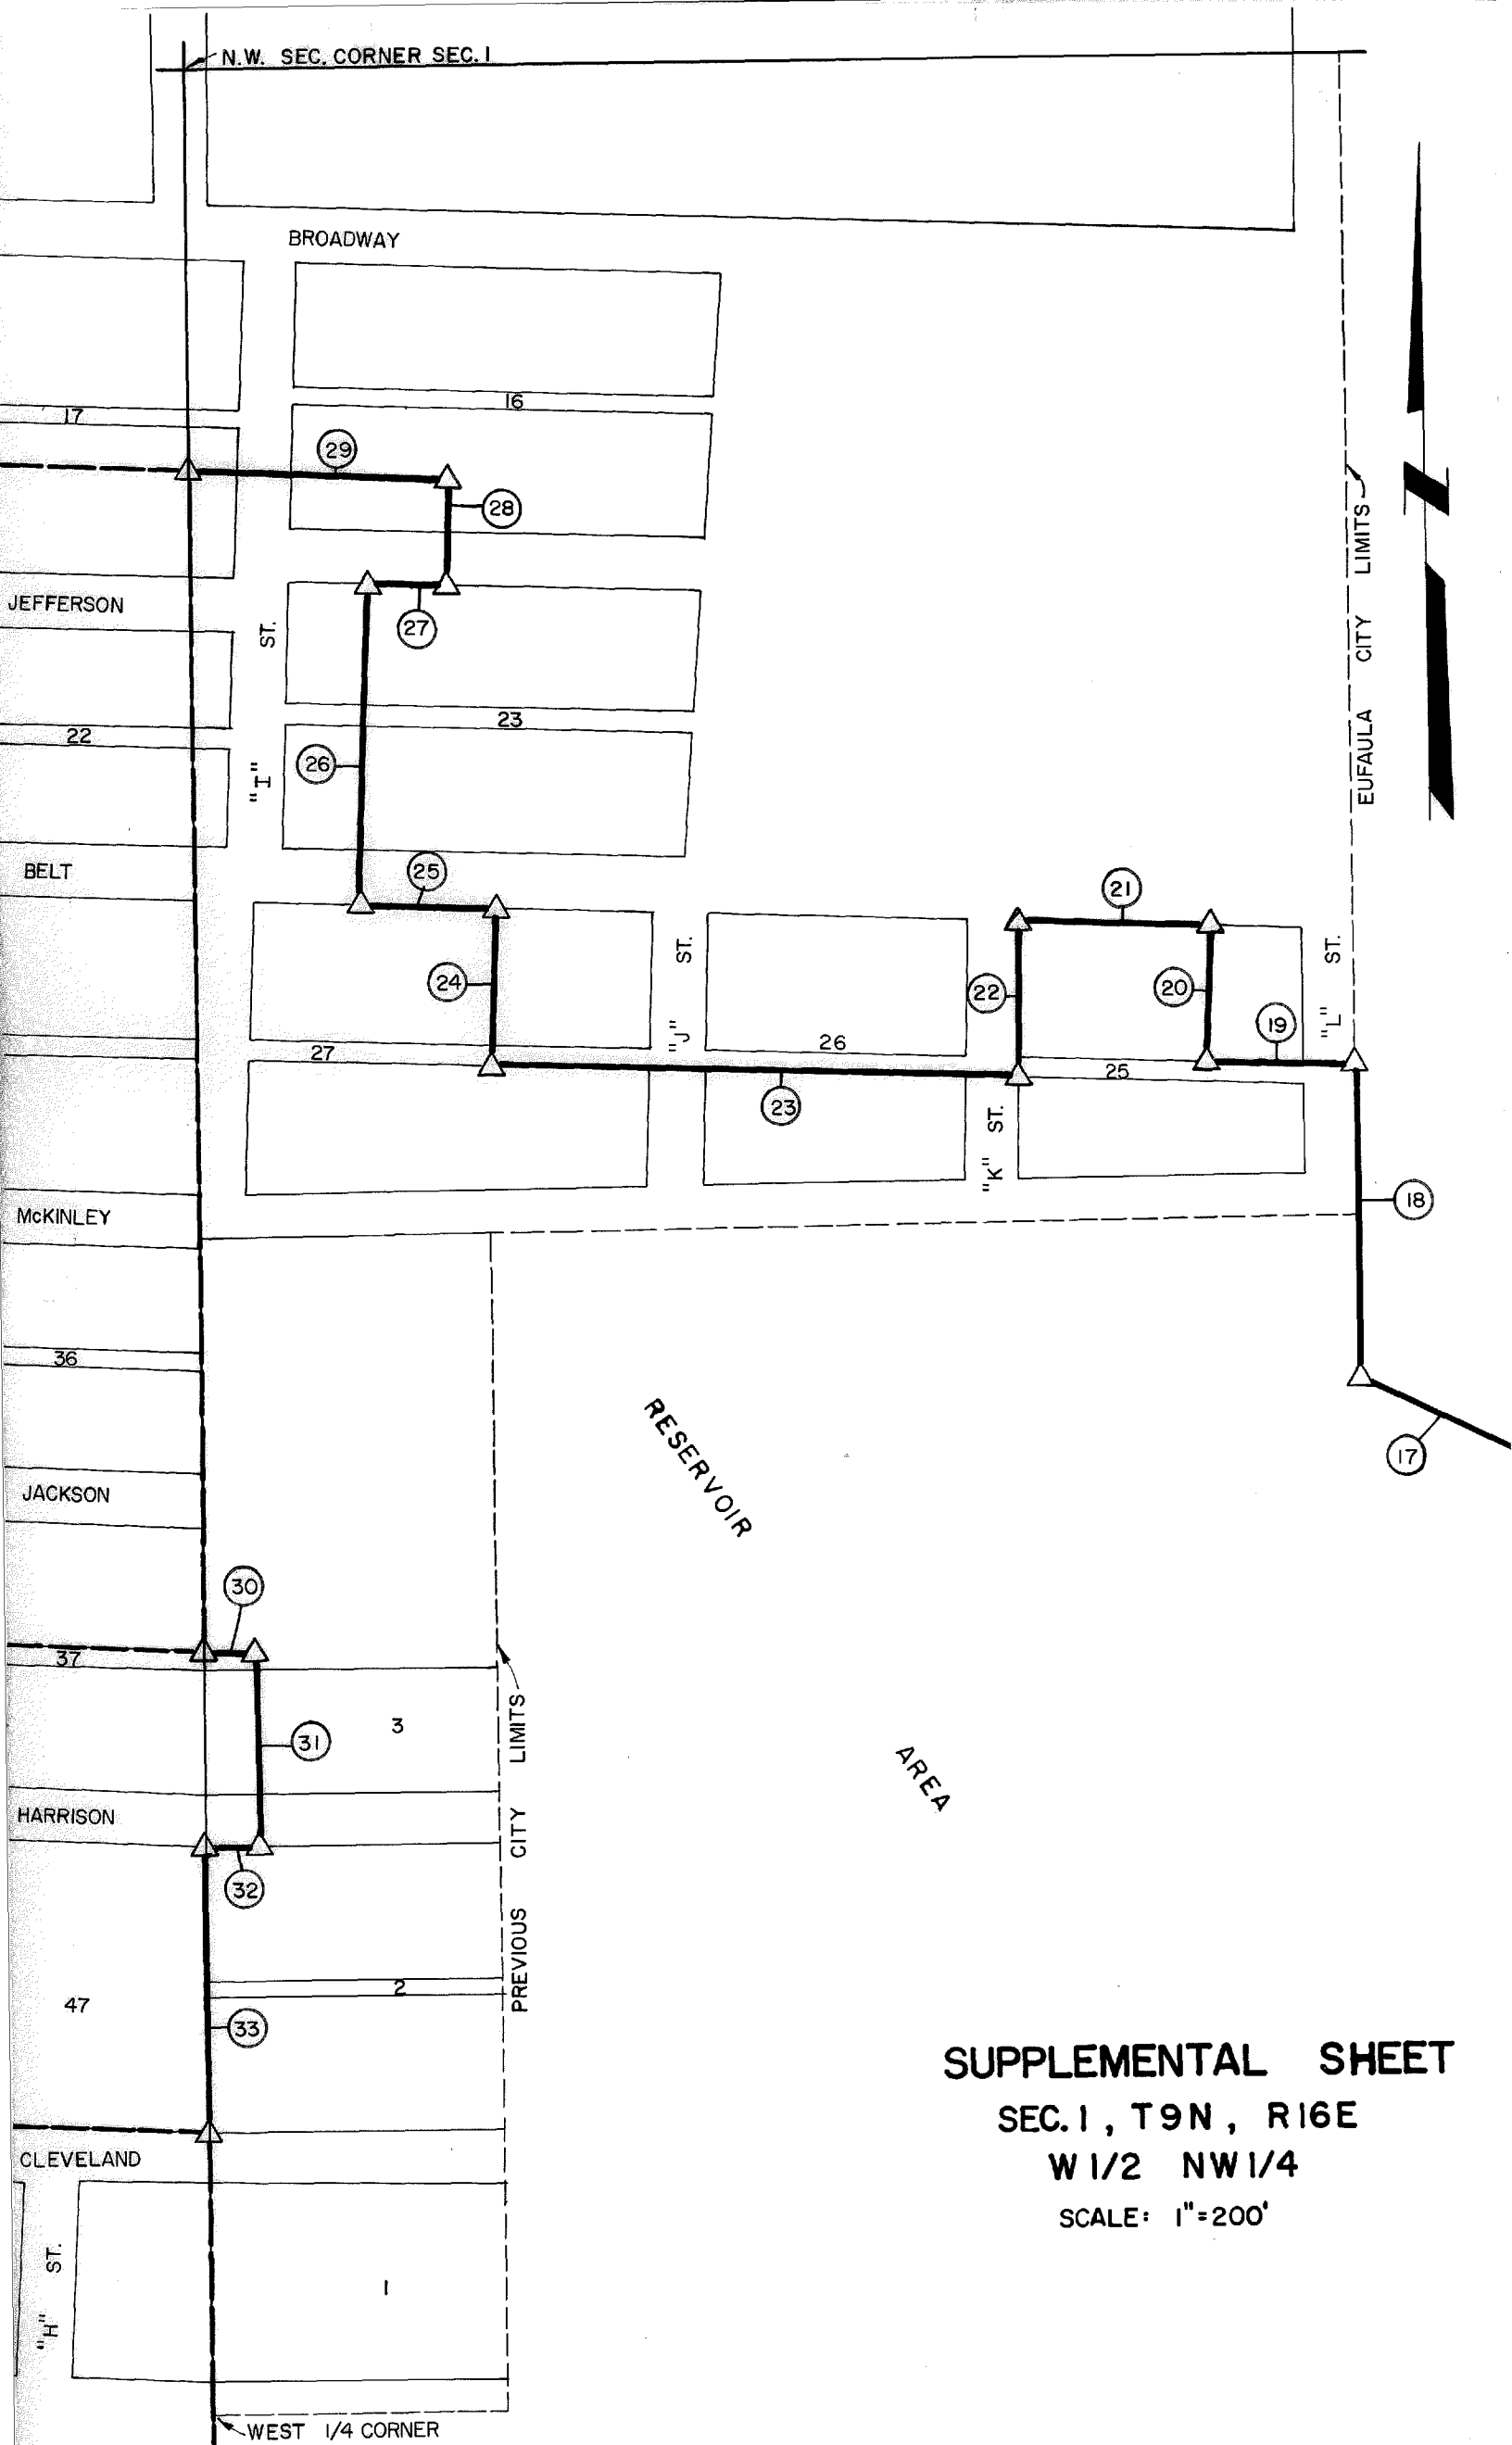

SUPPLEMENTAL SHEET
SEC. I, T9N, R16E
W 1/2 NW 1/4
SCALE: 1"=200'