LAKE CARL BLACKWELL OSSC

PIER #1

CROSS-SECTION

AS BUILT

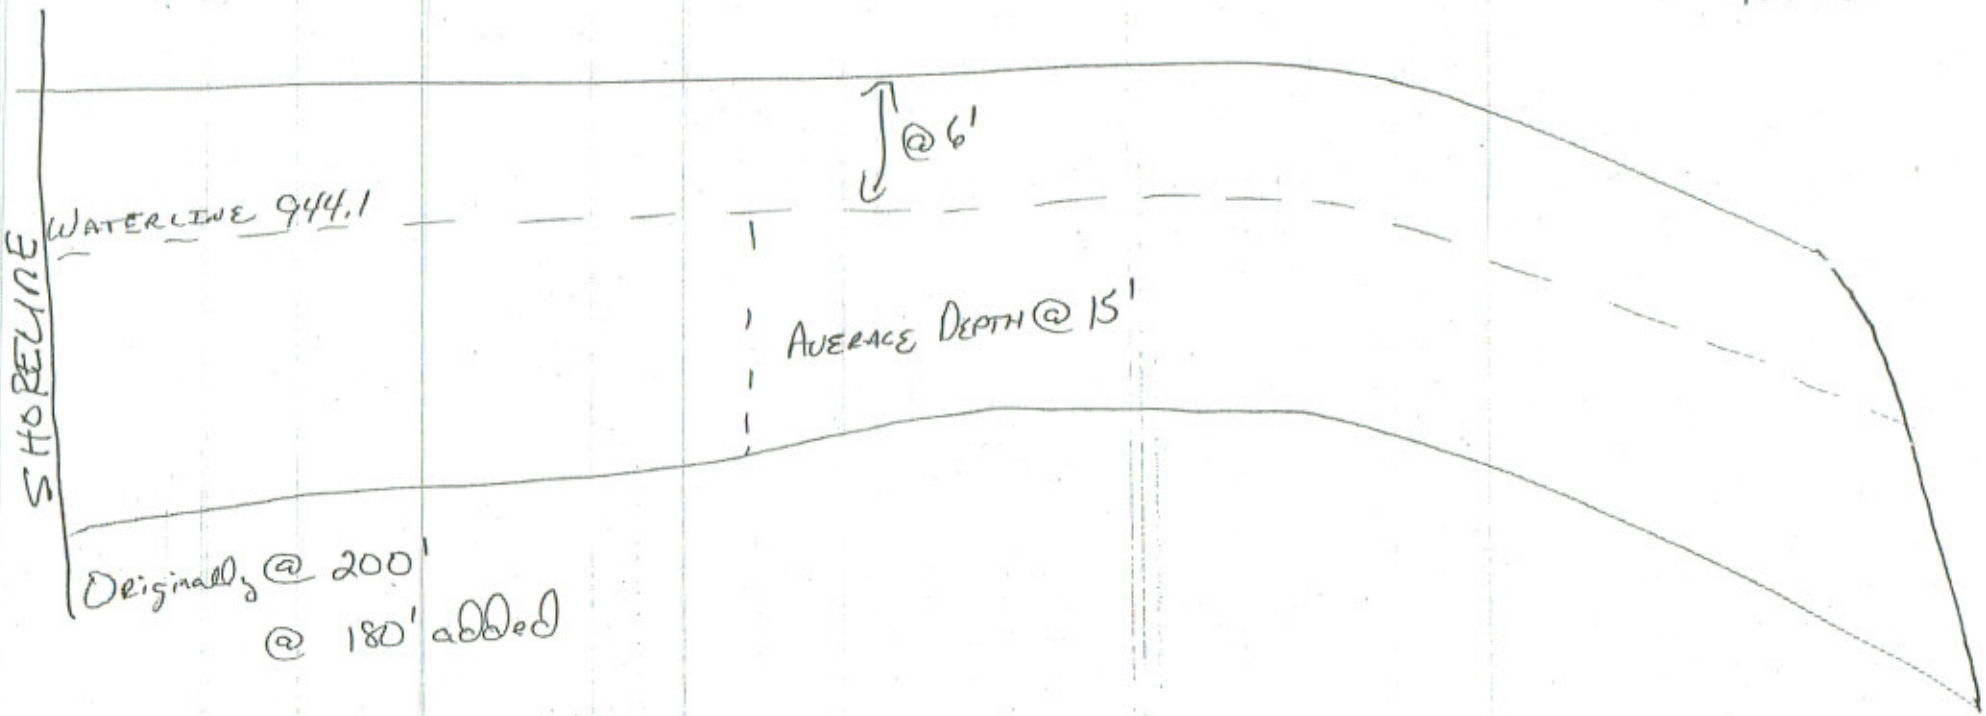

OKR2014559
OKLAHOMA STATE UNIVERSITY
LAKE CARL BLACKWELL
JETTY EXTENSION AND CONSTRUCTION
ENCLOSURE 3 OF 5