LAKE CARL BLACKWELL SKI POINT
PIER # 2
CROSS-SECTION
AS-BUILT

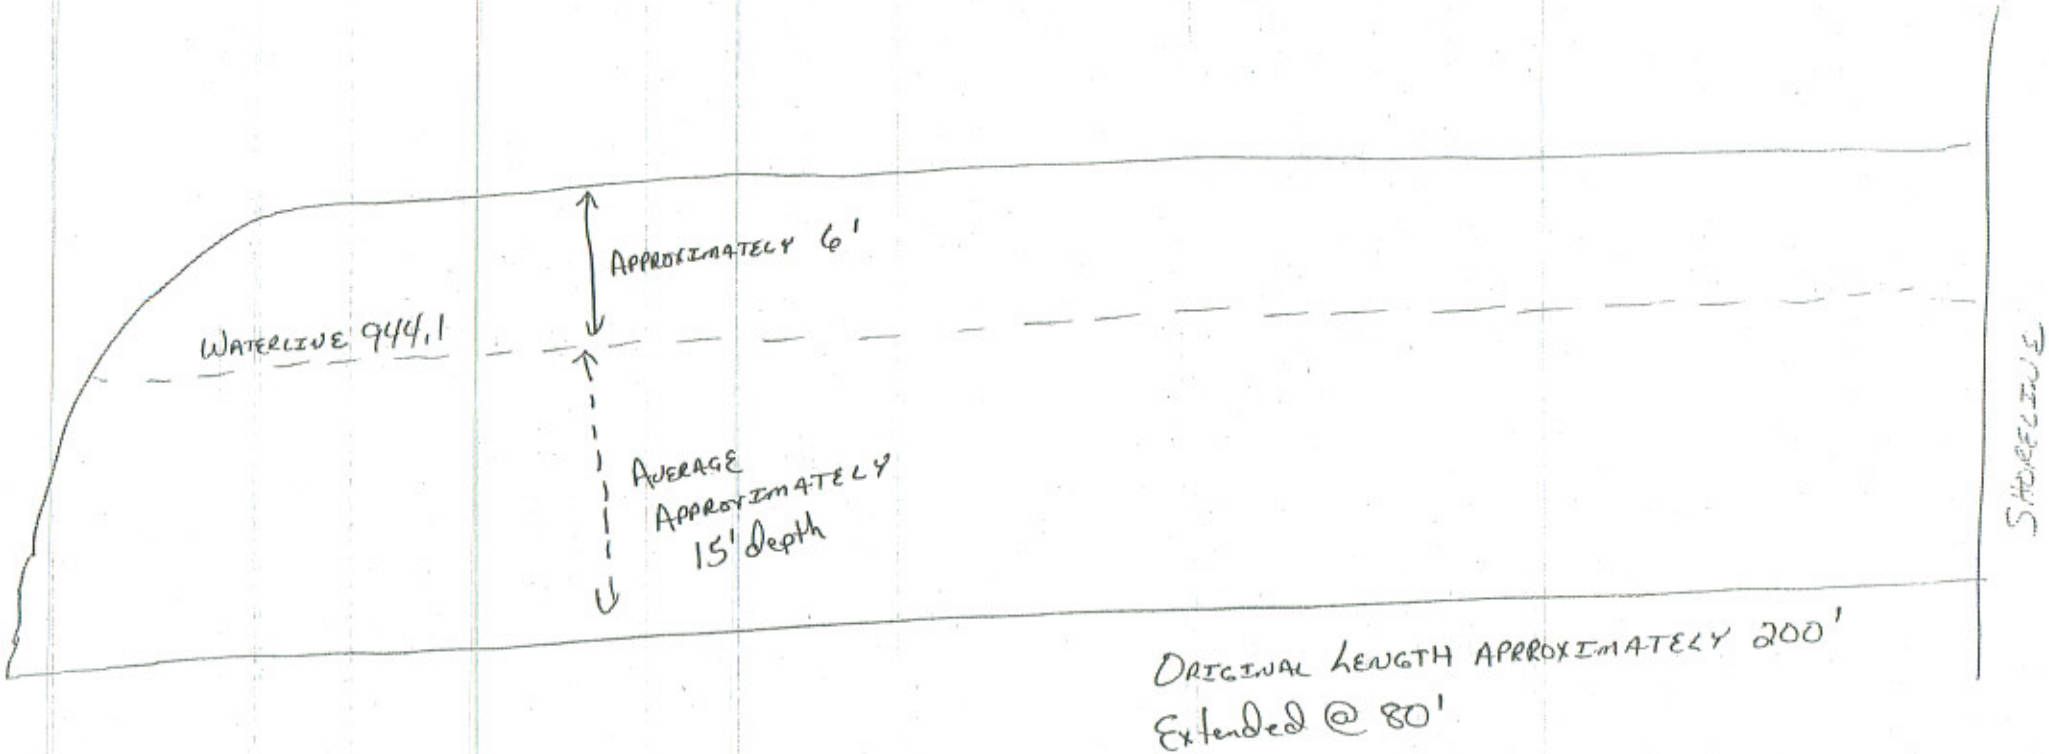

OKR2014559
OKLAHOMA STATE UNIVERSITY
LAKE CARL BLACKWELL
JETTY EXTENSION AND CONSTRUCTION
ENCLOSURE 4 OF 5