LAKE CARL BLACKWELL

BJC

PIER # 3

CROSS-SECTION

AS BUILT

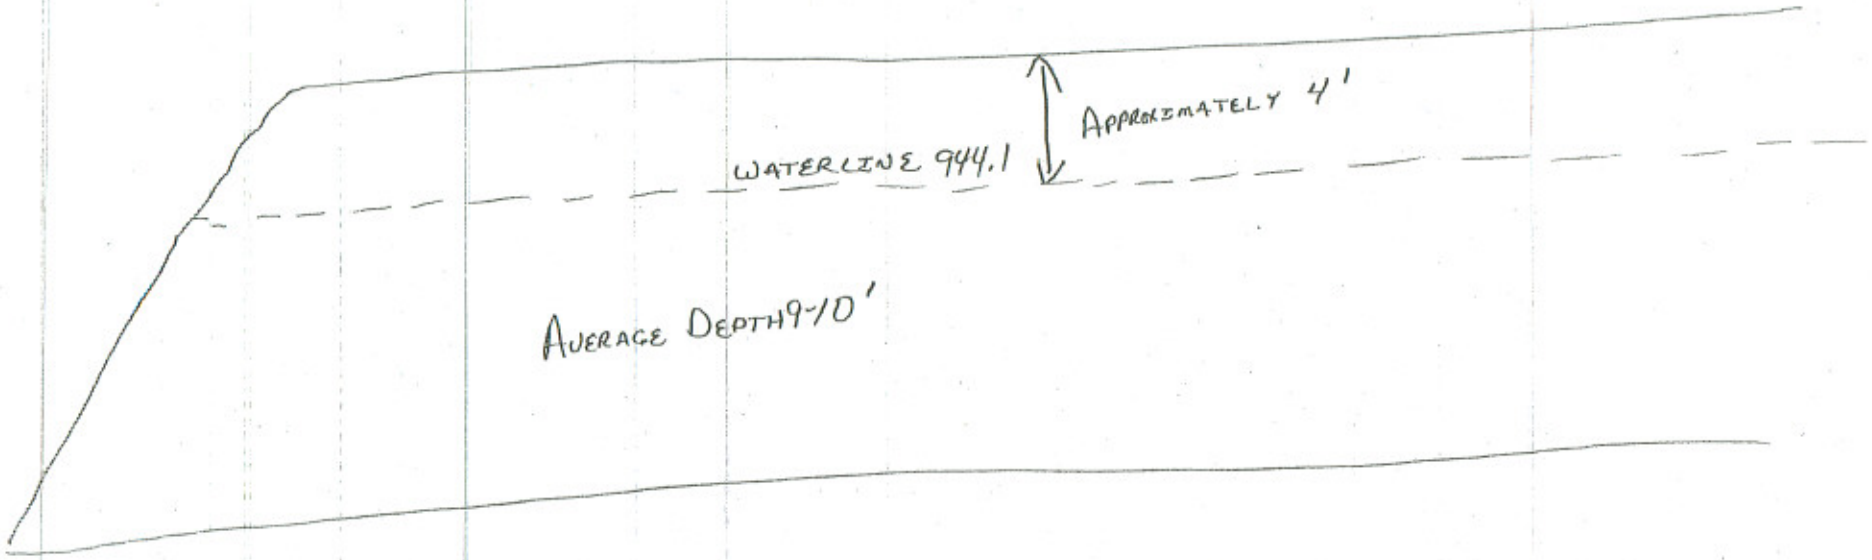

OKR2014559
OKLAHOMA STATE UNIVERSITY
LAKE CARL BLACKWELL
JETTY EXTENSION AND CONSTRUCTION
ENCLOSURE 5 OF 5