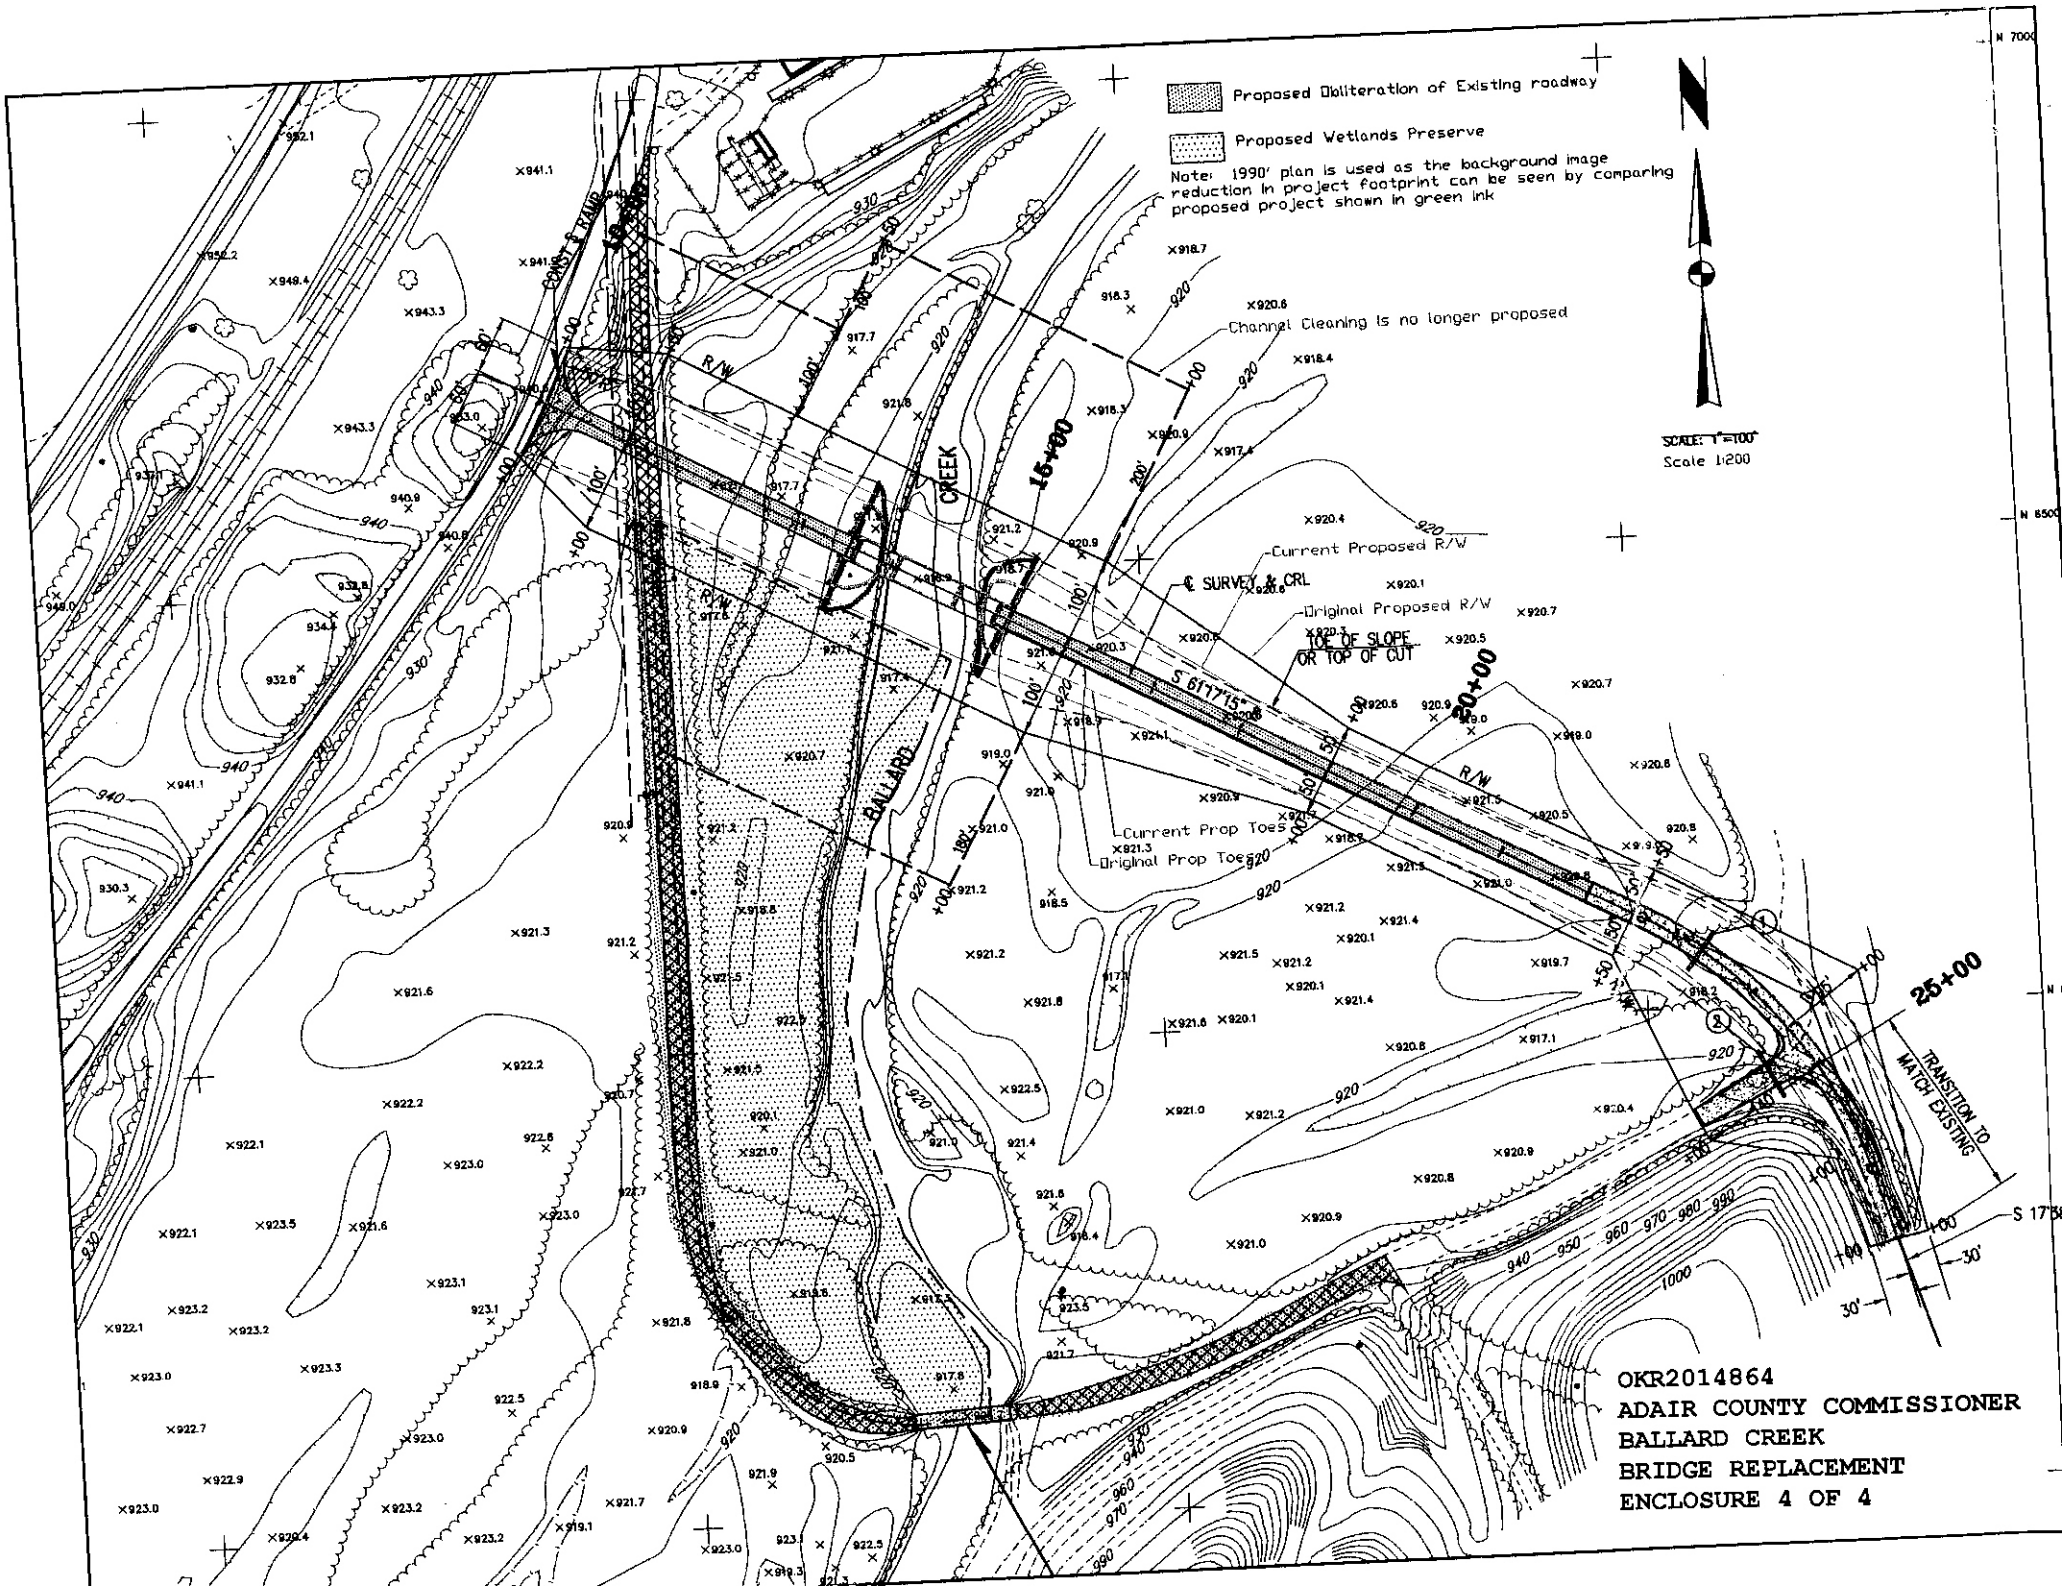
Proposed Obliteration of Existing roadway
Proposed Wetlands Preserve
Note: 1990' plan is used as the background image reduction in project footprint can be seen by comparing proposed project shown in green ink
Channel Cleaning is no longer proposed
SCALE: 1"=100'
Scale 1:200
Current Proposed R/W
℄ SURVEY & CRL
Original Proposed R/W
TOE OF SLOPE OR TOP OF CUT
Current Prop Toes
Original Prop Toes
BALLARD CREEK
15+00
20+00
25+00
TRANSITION TO MATCH EXISTING
R/W
S 61°17'15"
OKR2014864
ADAIR COUNTY COMMISSIONER
BALLARD CREEK
BRIDGE REPLACEMENT
ENCLOSURE 4 OF 4