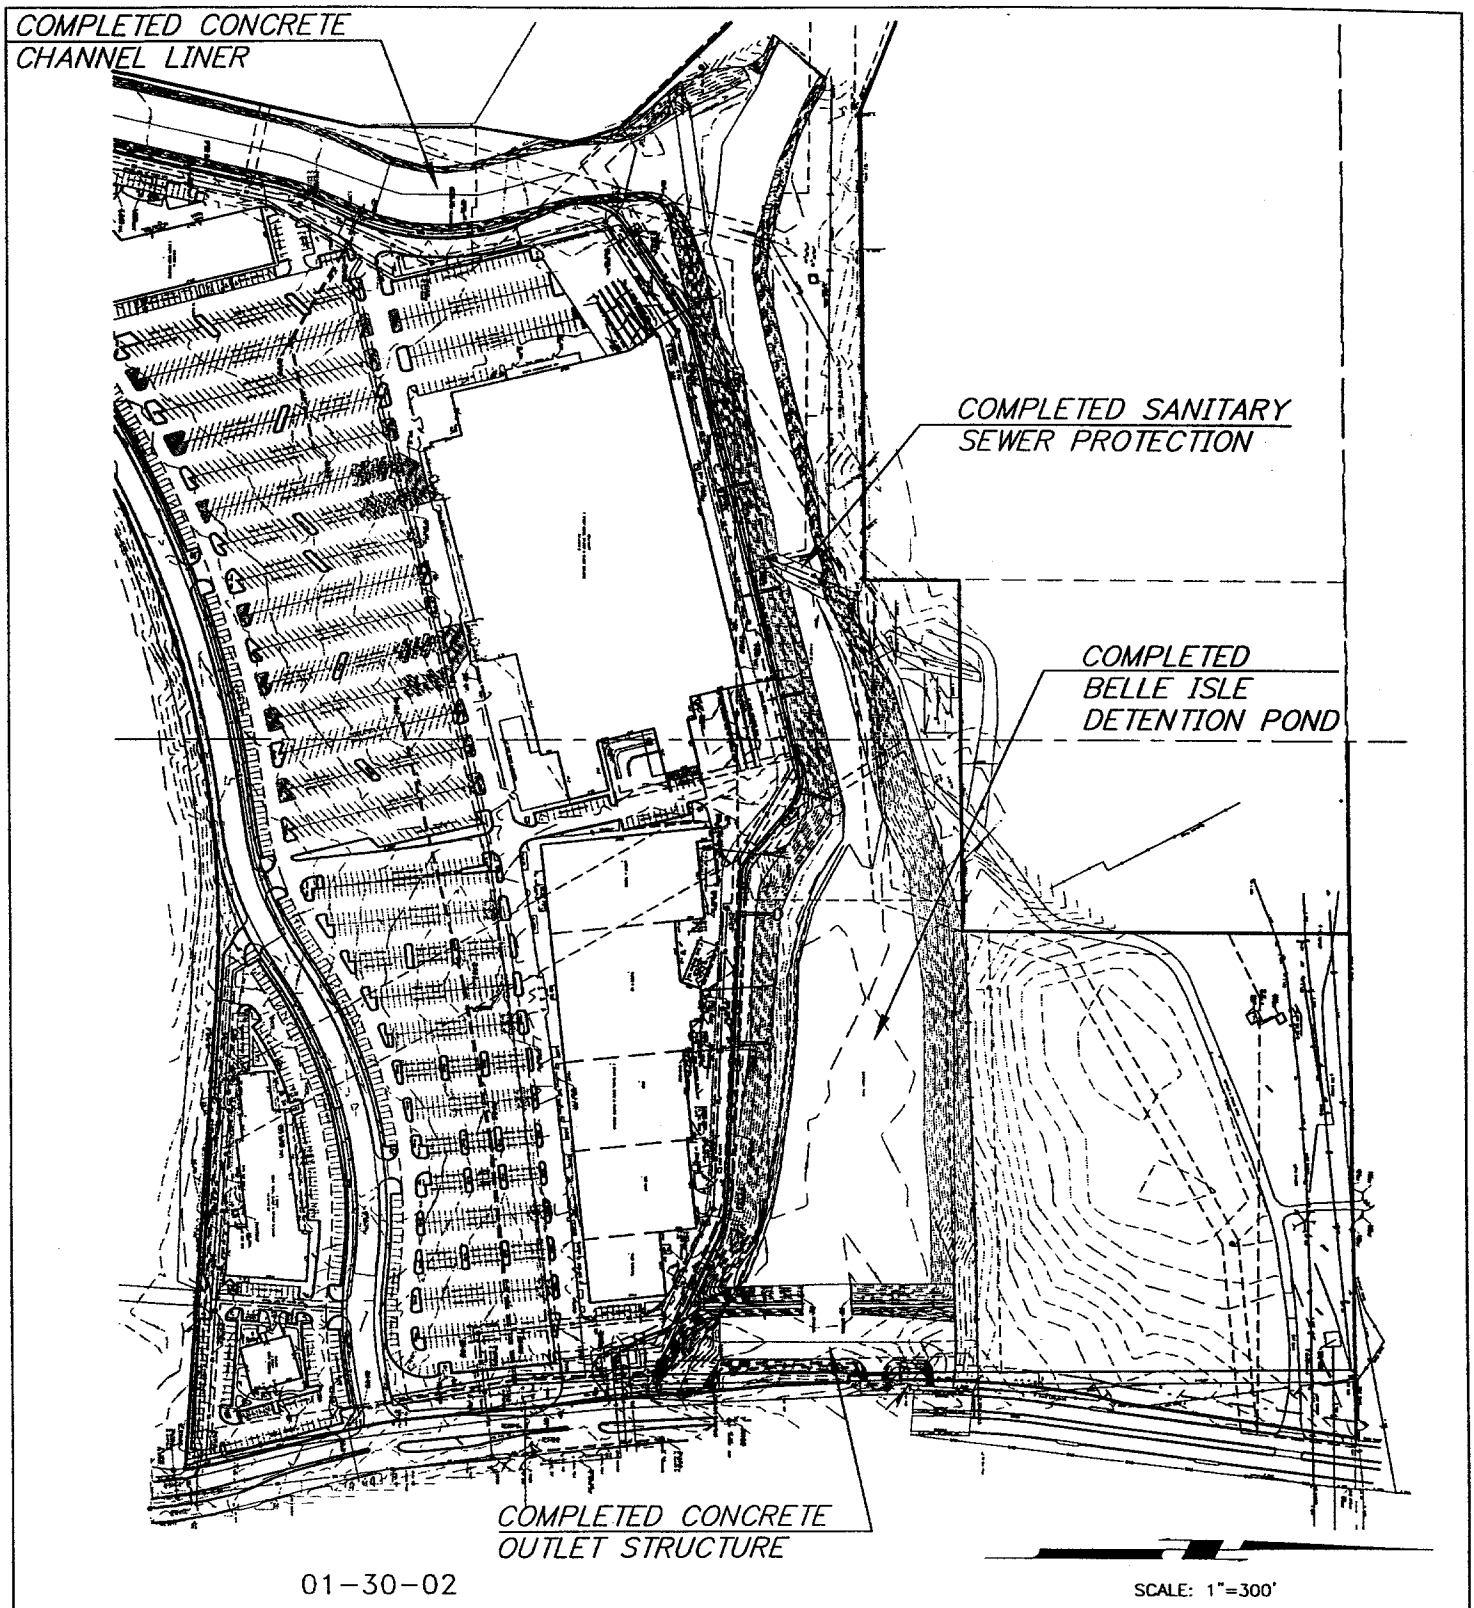

PROJECT

BELLE ISLE LAKE

DESCRIPTION

AS-BUILT SURVEY (10-31-00)

Copyright © 2002 Johnson & Associates, Inc.

ACAD FILE: H:\1900\AS-BUILT\vicinity maps\EXH-1900AS-BUILT-TOPO, 01/30/02 at 13:45, SCALE : 1, Last Update by: S.N.W.
XREFS LOADED: 1900AS-BUILT-TOPO ** OVERLAYS LOADED: None Loaded

OKR2003961
BELLE ISLE LAKE DEVELOPMENT
DEEP FORK RIVER
ENCLOSURE 2 of 6